CITY OF NEW YORK
Office of the President of the Borough of The Bronx
TOPOGRAPHICAL BUREAU

SECTION 63 ~~FINAL~~ MAPS
RECORD

DATED: July 29th 1926

Chief Engineer: Topographical Engineer:

President of the Borough of The Bronx.

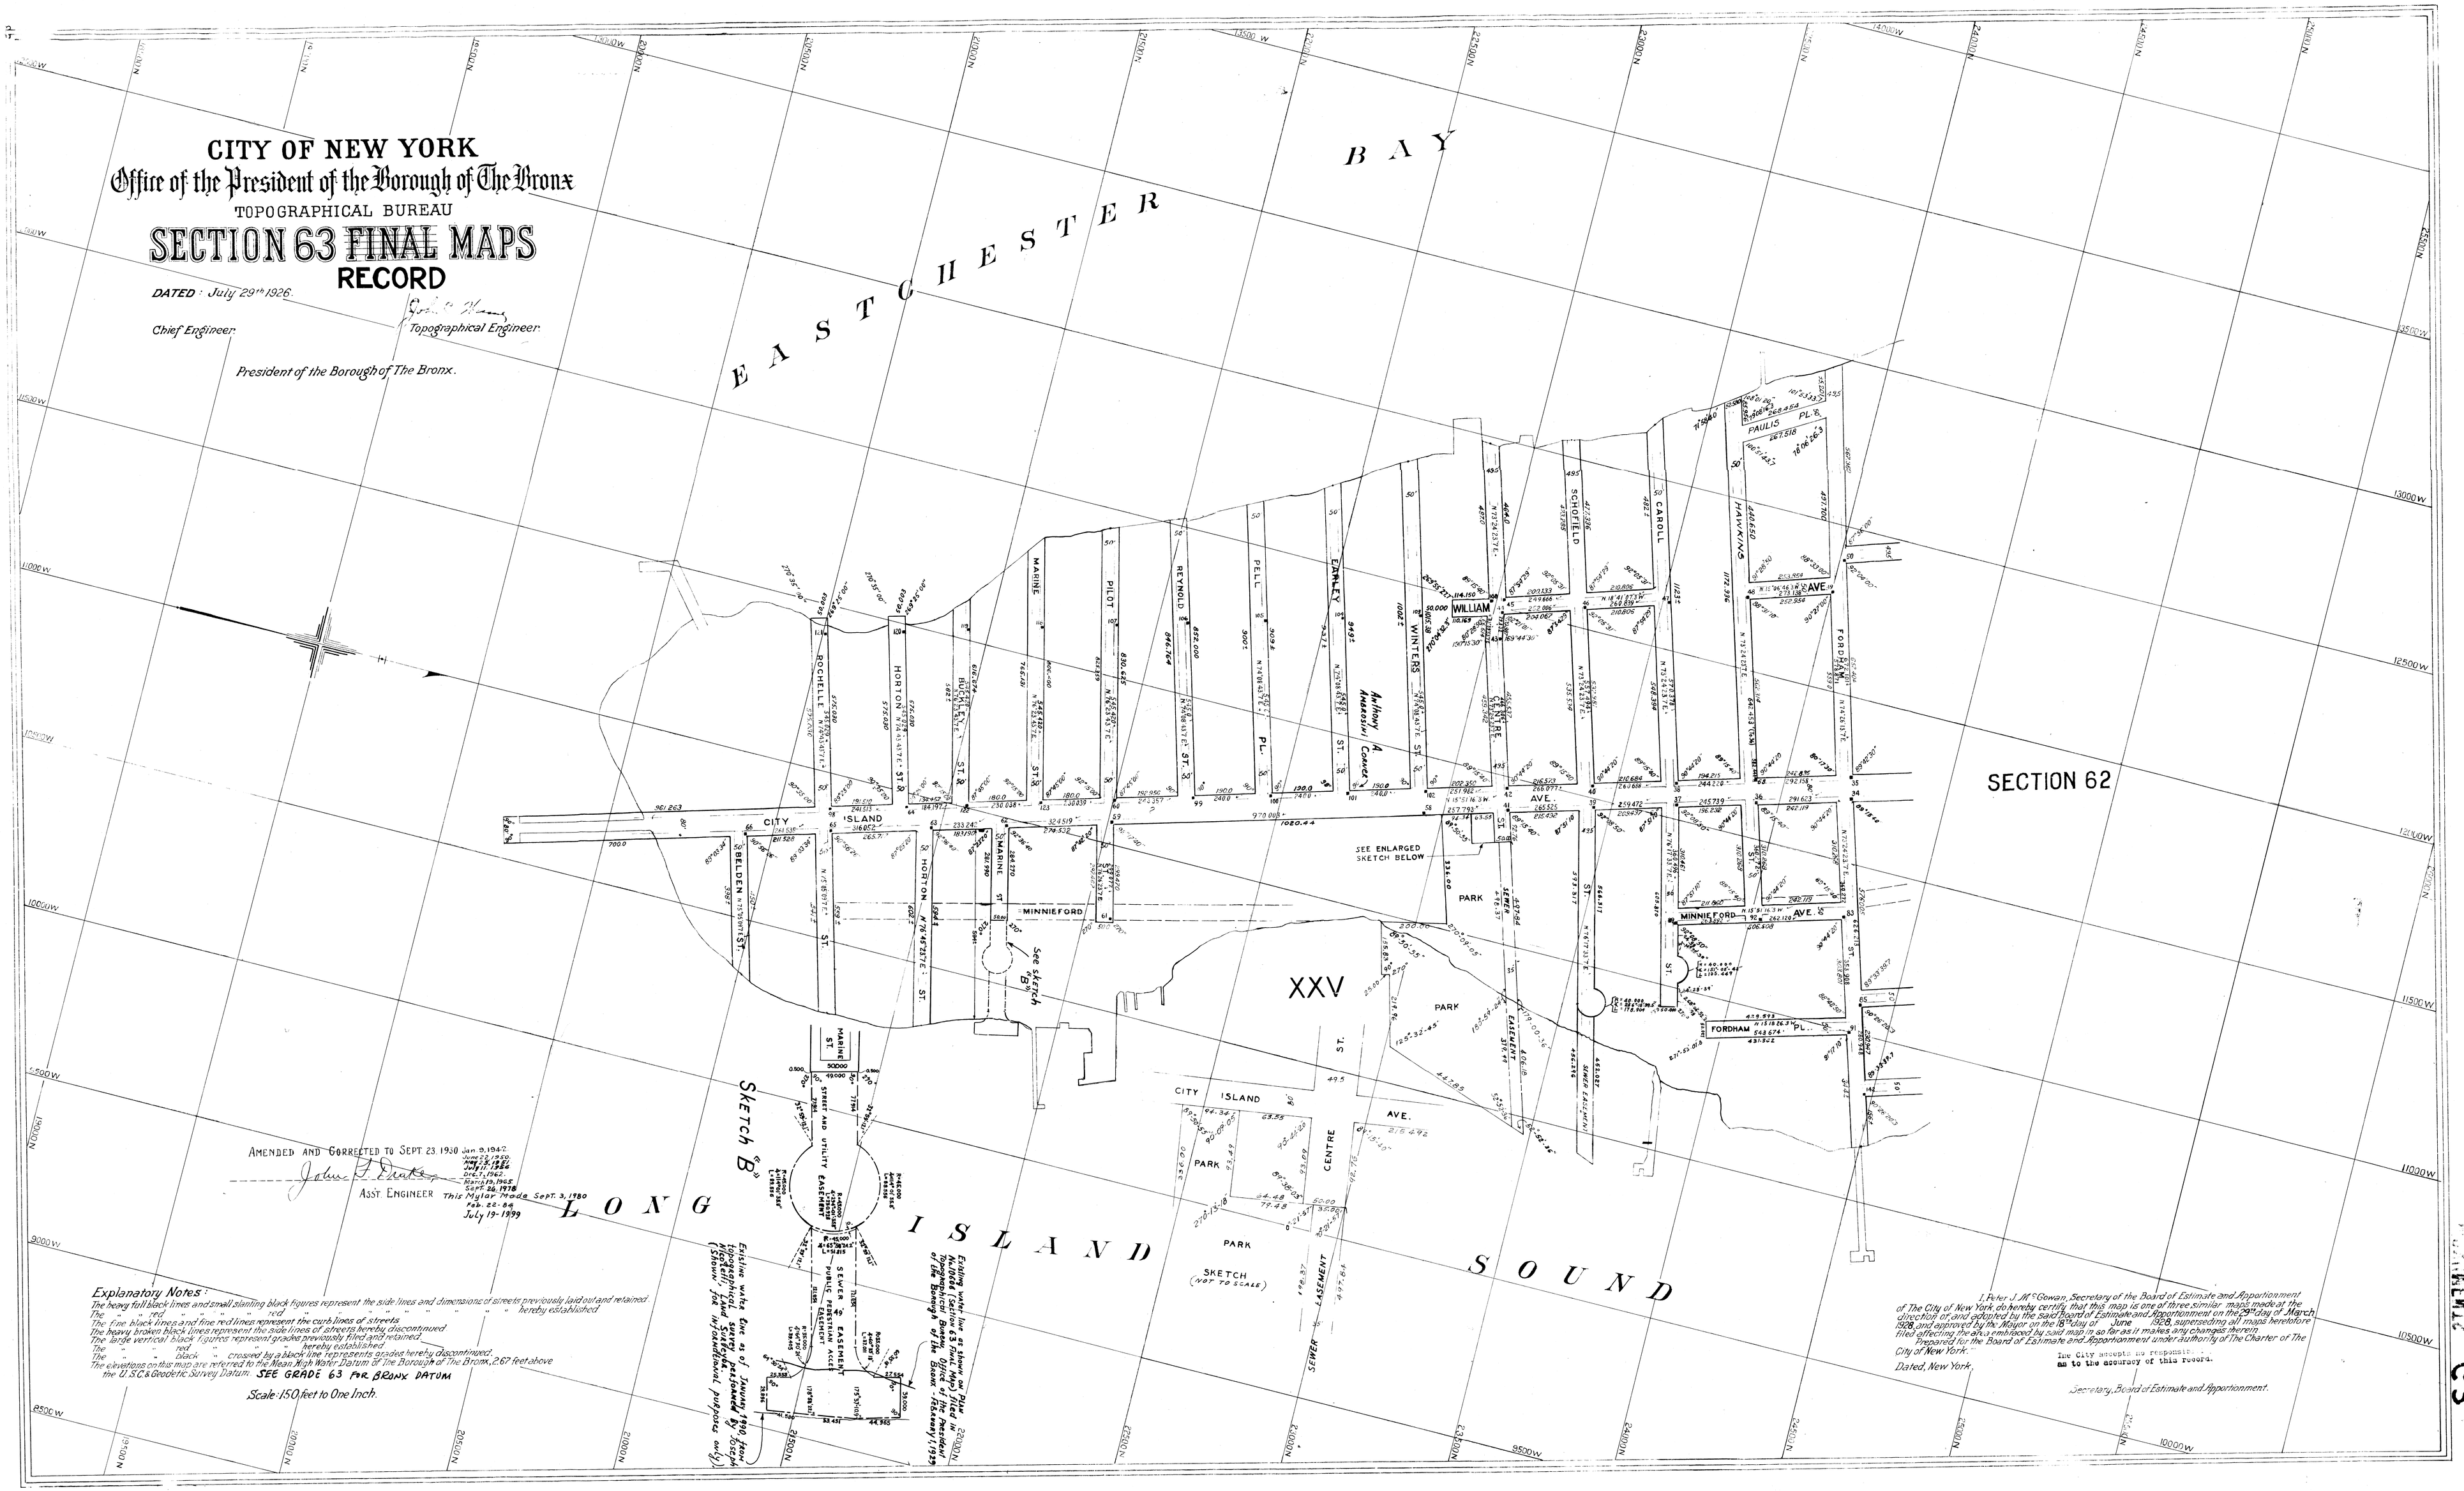

AMENDED AND CORRECTED TO SEPT. 23 1930 Jan. 9, 1942.
June 23, 1950.
June 18, 1956
July 17, 1956
March 19, 1965
Sept. 26, 1978
This Mylar Made Sept. 3, 1980
Feb. 25, 1986
July 19, 1999

John F. Drake
ASST. ENGINEER



Explanatory Notes:

The heavy full black lines and small slanting black figures represent the side lines and dimensions of streets previously laid out and retained
The " " red " " " " " " " " " " hereby established
The fine black lines and fine red lines represent the curb lines of streets
The heavy broken black lines represent the side lines of streets hereby discontinued
The large vertical black figures represent grades previously filed and retained.
The " " red " " " " hereby established
The " " black " crossed by a black line represents grades hereby discontinued.
The elevations on this map are referred to the Mean High Water Datum of The Bronx, 2.67 feet above the U.S.C.&Geodetic Survey Datum. SEE GRADE 63 FOR BRONX DATUM

Scale-150 feet to One Inch.

I, Peter J. McGowan, Secretary of the Board of Estimate and Apportionment of The City of New York, do hereby certify that this map is one of three similar maps made at the direction of, and adopted by the said Board of Estimate and Apportionment on the 29th day of March 1928, and approved by the Mayor on the 18th day of June 1928, superseding all maps heretofore filed affecting the area embraced by said map in so far as it makes any changes therein.
Prepared for the Board of Estimate and Apportionment under authority of The Charter of The City of New York.

Dated, New York.

The City accepts no responsibility as to the accuracy of this record.

Secretary, Board of Estimate and Apportionment.